

一层平面图 1:100

总建筑面积: 2151.70平方米
本层建筑面积: 601.21平方米

會意 DISCIPLINE	?? SIGNATURE
??	何个
???	澤惠
??	飛
??	每利
???	反町町
須知能讀 P.M	全英



?? CLIENT ??????????????

中交西南研发中心项目

2号地块(A区) 2#楼
?????

?? DRG SCALE 1:100 ???? PLOT SCALE A2(1 :

?? ?? COPYRIGHT RESERVED

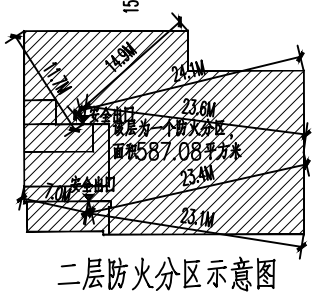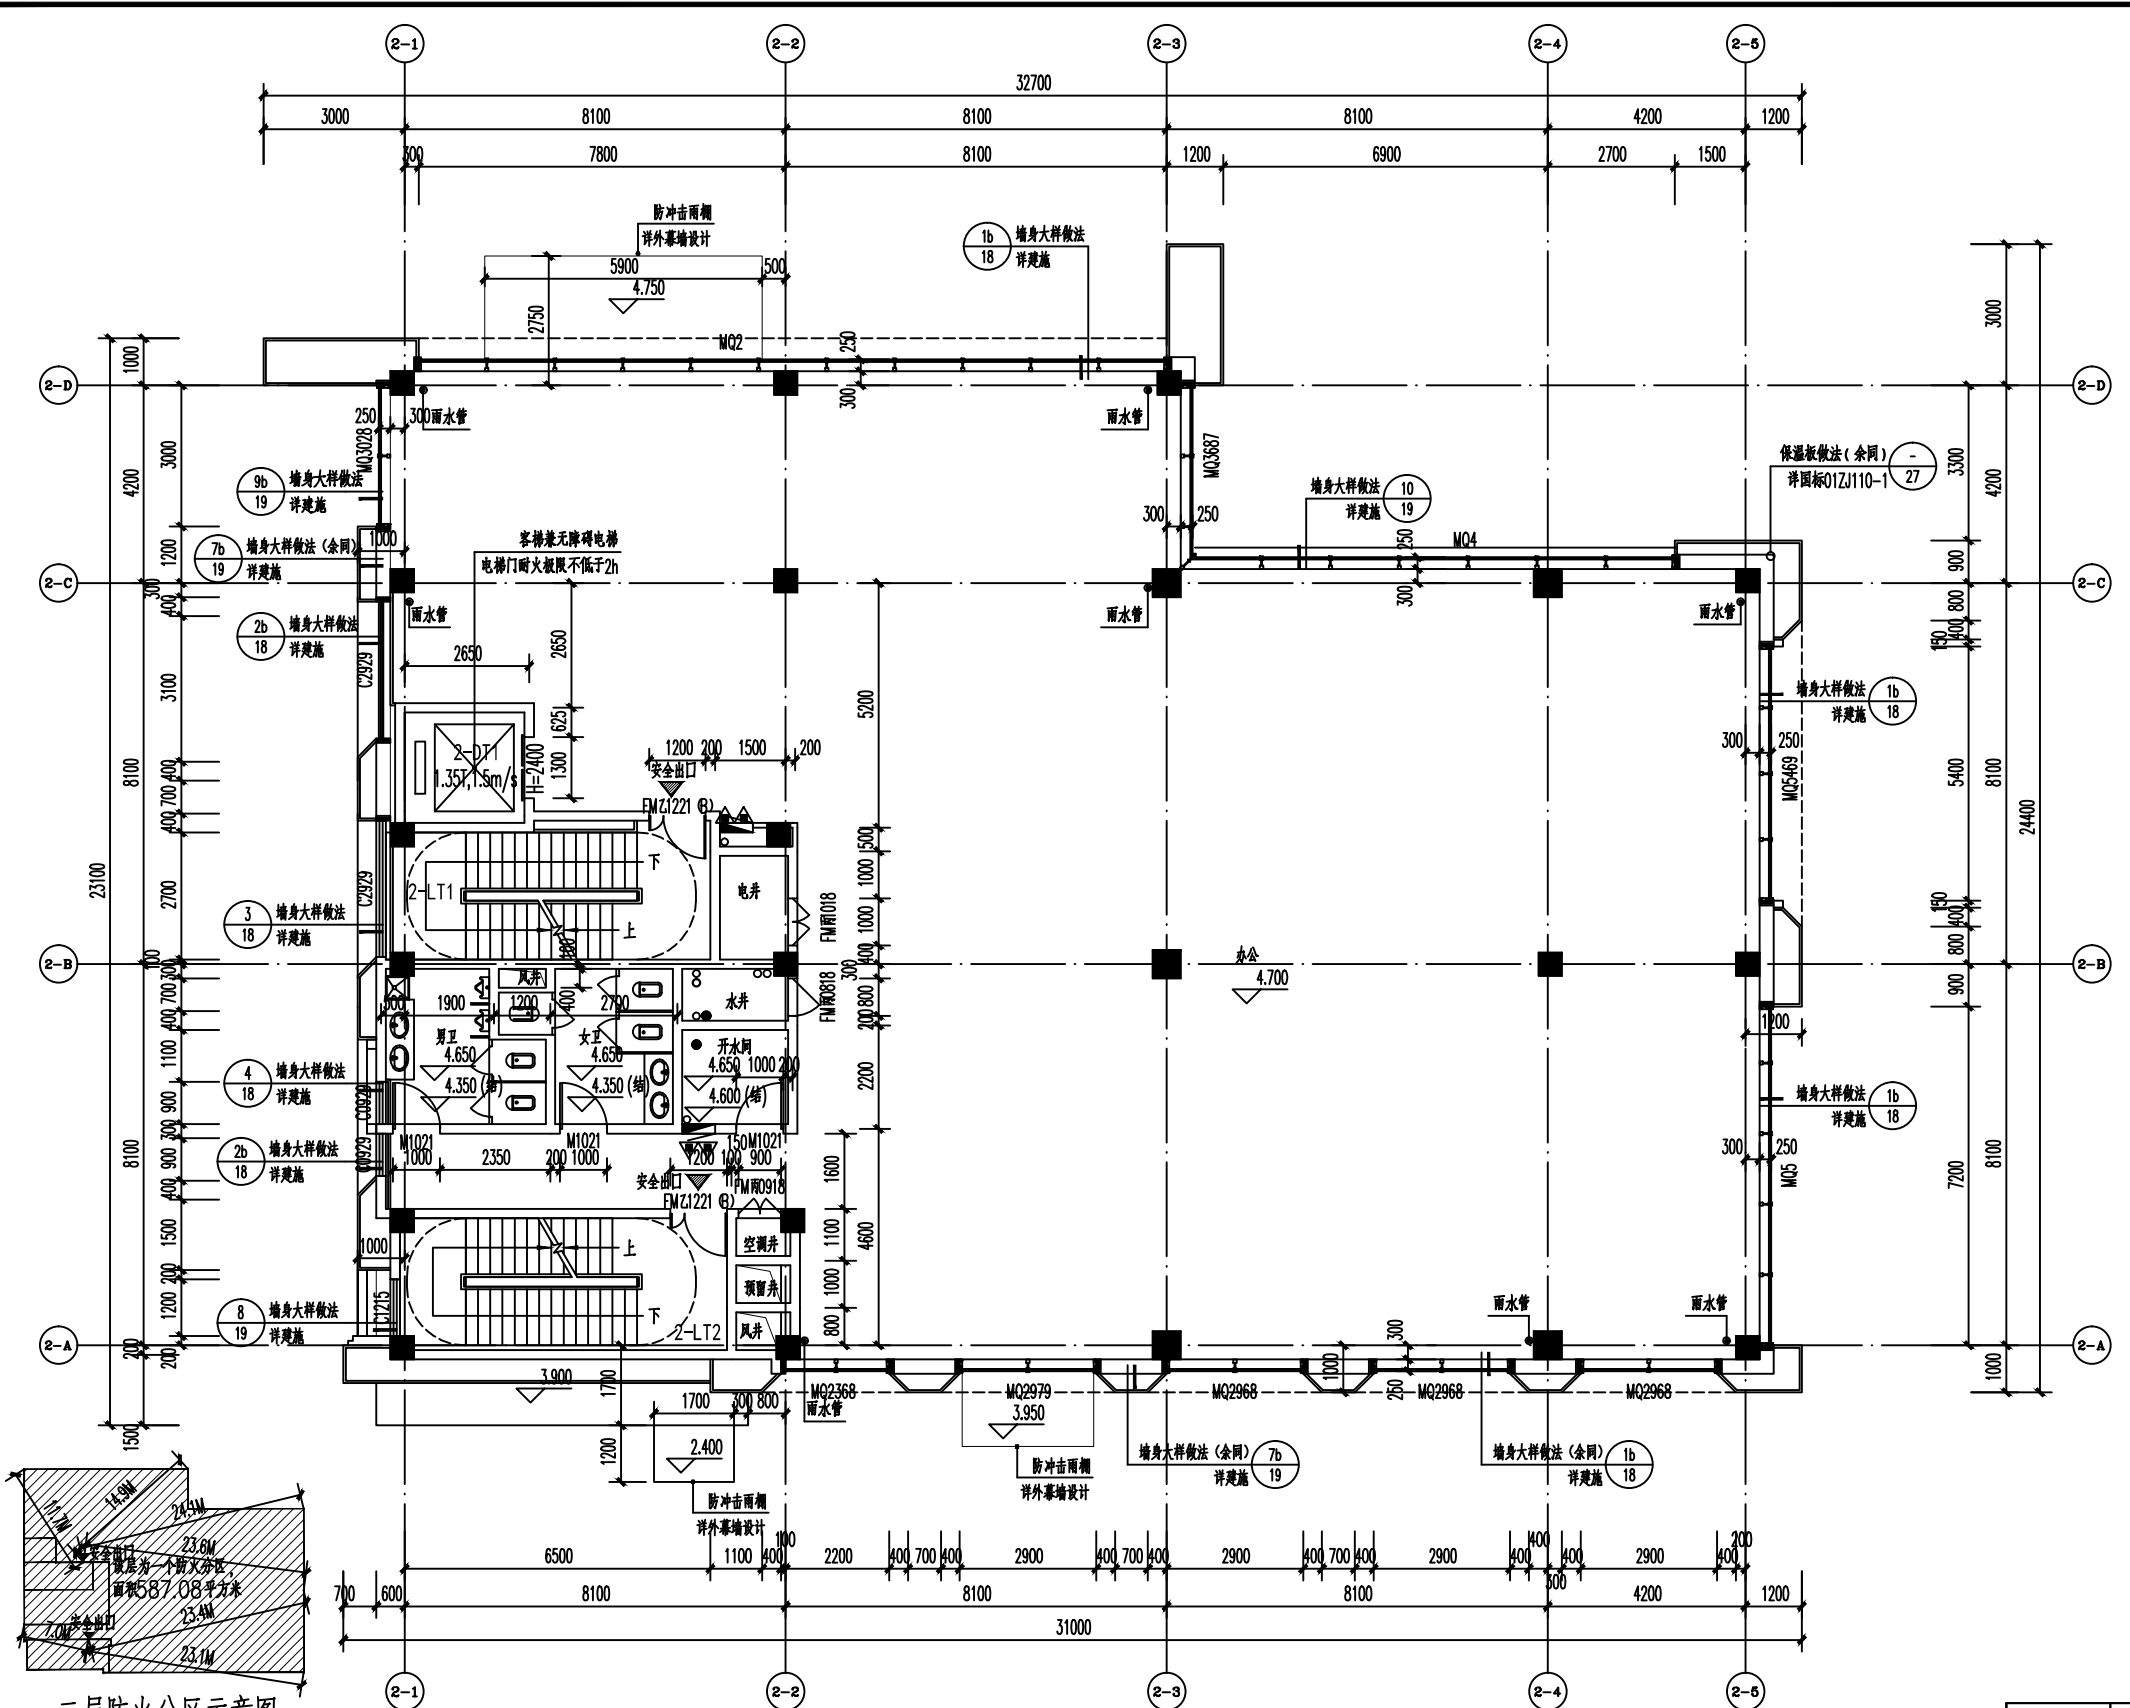

注:
本层建筑面积为586.65m²,按《建筑设计防火规范》
(GB50016-2014)要求
疏散宽度最小应为: 586.65X1/4/100=1.47m,
设计疏散宽度为: 1.20X2=2.4m大于1.47m, 故满足规范要求。

二层平面图 1:100
本层建筑面积: 586.65平方米

REFERENCE DRAWINGS

??	DRG No.	???	DRG TITLE.
----	---------	-----	------------

2	2017.12	施工	??	??	??	??	??	??
1	2017.09	设计	??	??	??	??	??	??
??	??	??	??	??	??	??	??	??
REV.	DATE	DESCRIPTION	BY	CHECKED	CHIEF DESIGNER	REVIEWED	APPROVED	??
??	APPROVED BY	??	DATE	2017.12	2017.12	2017.12	2017.12	2017.12
??	REVIEWED BY	??	DATE	2017.12	2017.12	2017.12	2017.12	2017.12
??	CHIEF DESIGNER	??	DATE	2017.12	2017.12	2017.12	2017.12	2017.12
??	CHECKED BY	??	DATE	2017.12	2017.12	2017.12	2017.12	2017.12
??	DESIGNED BY	??	DATE	2017.12	2017.12	2017.12	2017.12	2017.12
??	CLIENT	????????????	??	??	??	??	??	??


CCCC - FHDI ENGINEERING CO., LTD.

中交西南研发中心项目

2号地块(A区) 2#楼
二层平面图


??	15S219-SS-DWG-JZ-A0206	??	2
DRG NO.	15S219-SS-DWG-JZ-A0206	REV.	2
??	DRG SCALE 1:100	??	PLOT SCALE A2 (1:1)
??	??	??	??


COPYRIGHT RESERVED

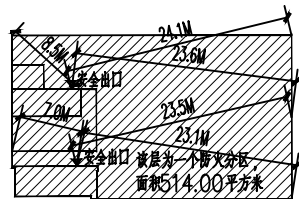

本层建筑面积： 513.87平方米


专业 DISCIPLINE	?? SIGNATURE
??	何
???	陈
??	陈
??	陈
???	陈
项目助理 P.M	陈

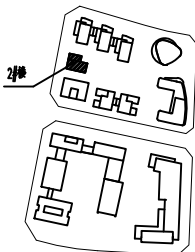
										???? REFERENCE DRAWINGS														
?? DRG No.					???? DRG TITLE.																			
																								
2	2017.12	竣工图	??	??	??	???																		
1	2017.09	???	结构	??	??	??	??	??	??	??	??	??	??	??	??	??	??	??	??	??	??	??	??	??
?? REV.	?? DATE	?? DESCRIPTION	?? BY	?? CHECKED	?? CHIEF DESIGNER	?? REVIEWED	?? APPROVED																	
?? APPROVED BY										?? DATE														
?? REVIEWED BY										?? DATE 2017.12														
???? CHIEF DESIGNER										?? DATE 2017.12														
?? CHECKED BY										?? DATE 2017.12														
?? DESIGNED BY										?? DATE 2017.12														
?? CLIENT										????????????????														
 ?????????????????????? CCCC - FHD ENGINEERING CO., LTD.																								
中交西南研发中心项目																								
2号地块(A区) 2#楼 三层平面图																								
?? DRG NO.	15S219-SS-DWG-JZ-A0207																			?? REV.	2			
?? DRG SCALE	1:100																			???? PLOT SCALE A2(1 : 1)				
? ? ? ? ? COPYRIGHT RESERVED																								

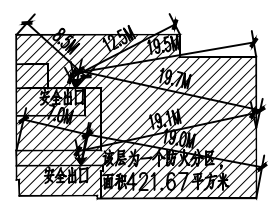

本层建筑面积： 421.22平方米

专业 DISCIPLINE	?? SIGNATURE
??	何丁
???	陈勇
??	陈
??	陈
???	陈
项目 课程 P.M	陈

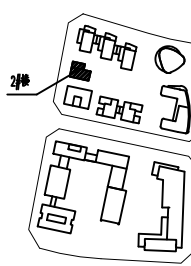		????? REFERENCE DRAWINGS					
?? DRG No.		????? DRG TITLE.					
							
2	2017.12	施工队	??	??	??	???	
1	2017.09	???	结构	中修	中修	景观修	
?? REV.	?? DATE	????? DESCRIPTION	?? BY	?? CHECKED	????? CHIEF DESIGNER	?? REVIEWED	?? APPROVED
?? APPROVED BY				?? DATE			
?? REVIEWED BY				?? DATE 2017.12			
?? CHIEF DESIGNER				?? DATE 2017.12			
?? CHECKED BY				?? DATE 2017.12			
?? DESIGNED BY				?? DATE 2017.12			
?? CLIENT ?????????????????							
 ?????????????????? CCCC - FHDI ENGINEERING CO., LTD.							
中交西南研发中心项目							
2号地块(A区) 2#楼 四层平面图							
?? DRG NO.	15S219-SS-DWG-JZ-A0208					?? REV.	2
?? DRG SCALE	1:100		?????	PLOT SCALE A2 (1 : 1)			
? ? ? ? COPYRIGHT RESERVED							

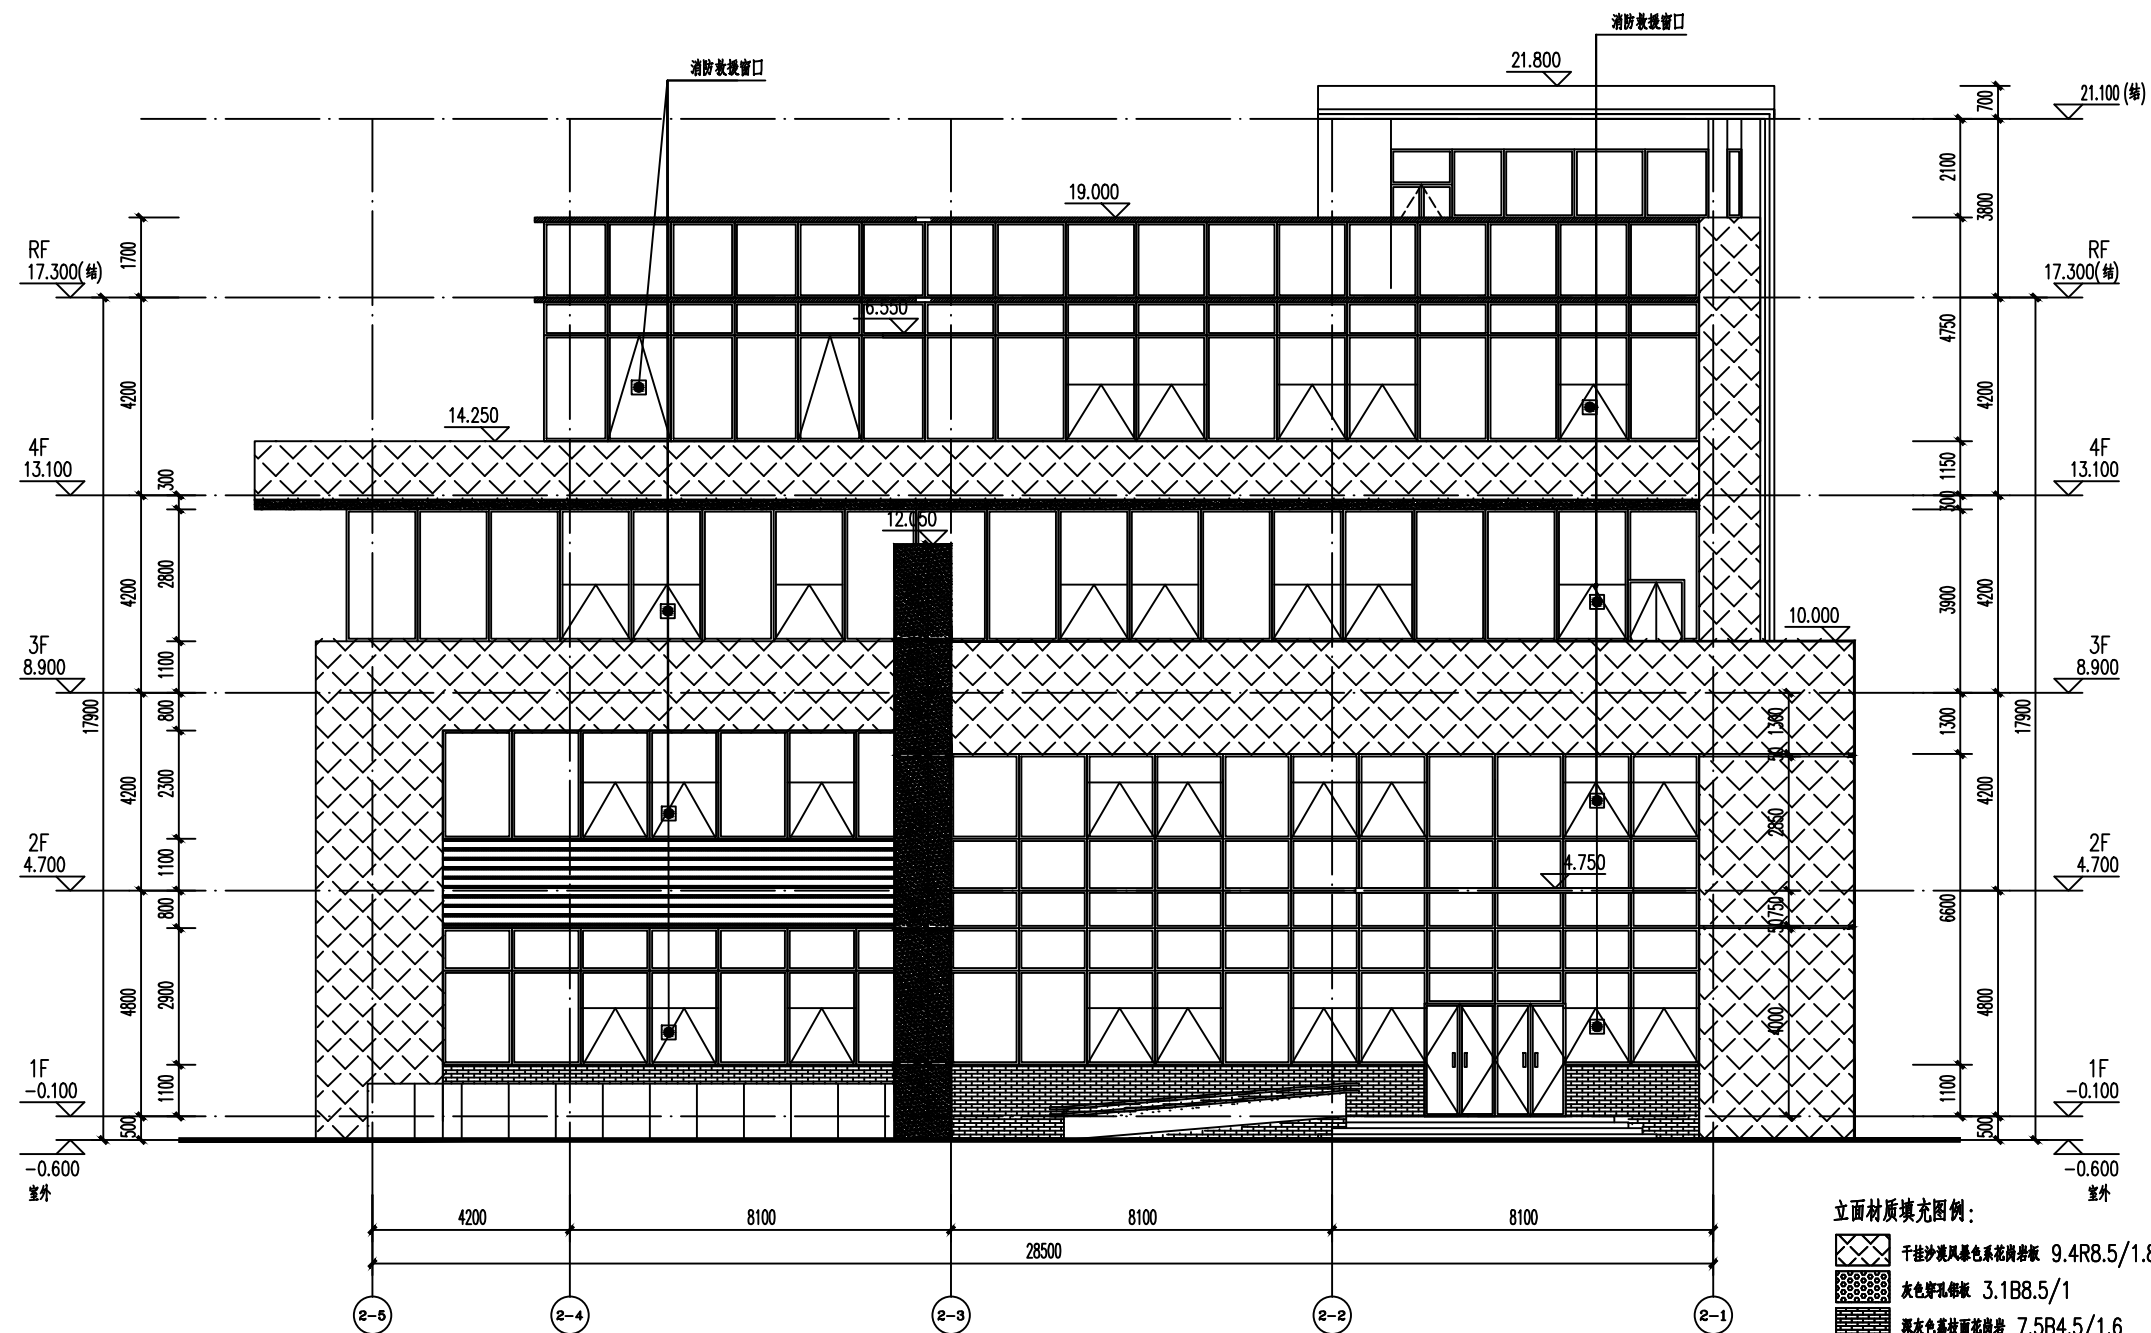

2-5轴~2-1轴立面图 1:100

立面材质填充图例:

- 干挂沙漏网暴色系花岗岩板 9.4R8.5/1.8
- 灰色穿孔铝板 3.1B8.5/1
- 深灰色荔枝面花岗岩 7.5B4.5/1.6
- 干挂仿木色铝板 06RY7.5/4.8
- 暗红色百叶 1.9Y6/5.6

专业	DISCIPLINE	??	SIGNATURE
??	??	??	??
??	??	??	??
REFERENCE DRAWINGS

??	DRG No.	???	DRG TITLE.
----	---------	-----	------------

2	2017.12	施工	??	??	??	??	??	??
1	2017.09	???	??	??	??	??	??	??
??	??	???	??	??	??	??	??	??
REV.	DATE	DESCRIPTION	BY	CHECKED	CHIEF DESIGNER	REVIEWED	APPROVED	
??	APPROVED BY	??	DATE					
??	REVIEWED BY	??	DATE	2017.12				
???	CHIEF DESIGNER	??	DATE	2017.12				
??	CHECKED BY	??	DATE	2017.12				
??	DESIGNED BY	??	DATE	2017.12				
??	CLIENT	????????????						


CCCC - FHDI ENGINEERING CO., LTD.

中交西南研发中心项目

2号地块(A区) 2#楼


2-5 2-1

??	15S219-SS-DWG-JZ-A0210	??	2
DRG NO.		REV.	
??	DRG SCALE 1:100	???	PLOT SCALE A2(1:1)
??	???	???	COPYRIGHT RESERVED

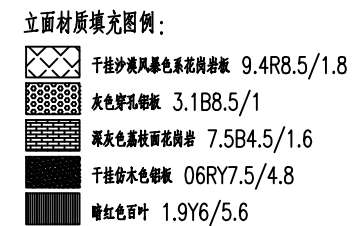

名字 DISCIPLINE	?? SIGNATURE
??	何
???	潘勇
??	龍
??	呂明
???	吳明時
項建強 P.M	林

???? REFERENCE DRAWINGS							
?? DRG No.		???? DRG TITLE.					
2	2017.12	竣工图	??	??	??	???	
1	2017.09	??? ?	??	??	??	??	
REV.	?? DATE	???? DESCRIPTION	?? BY	?? CHECKED	???? CHIEF DESIGNED	?? REVIEWED	?? APPROVED
?? APPROVED BY				?? DATE			
?? REVIEWED BY				?? DATE 2017.12			
???? CHIEF DESIGNER				?? DATE 2017.12			
?? CHECKED BY				?? DATE 2017.12			
?? DESIGNED BY				?? DATE 2017.12			
?? CLIENT				????????????????			
?????????????????? CCCC – FHD ENGINEERING CO., LTD.							
中交西南研发中心项目							
2号地块(A区) 2#楼 ②-③ ②-④ ???							
?? DRG NO.	15S219-SS-DWG-JZ-A0211					?? REV.	2
?? DRG SCALE	1:100		????		PLOT SCALE A2(1 : 1)		
? ? ? ? COPYRIGHT RESERVED							

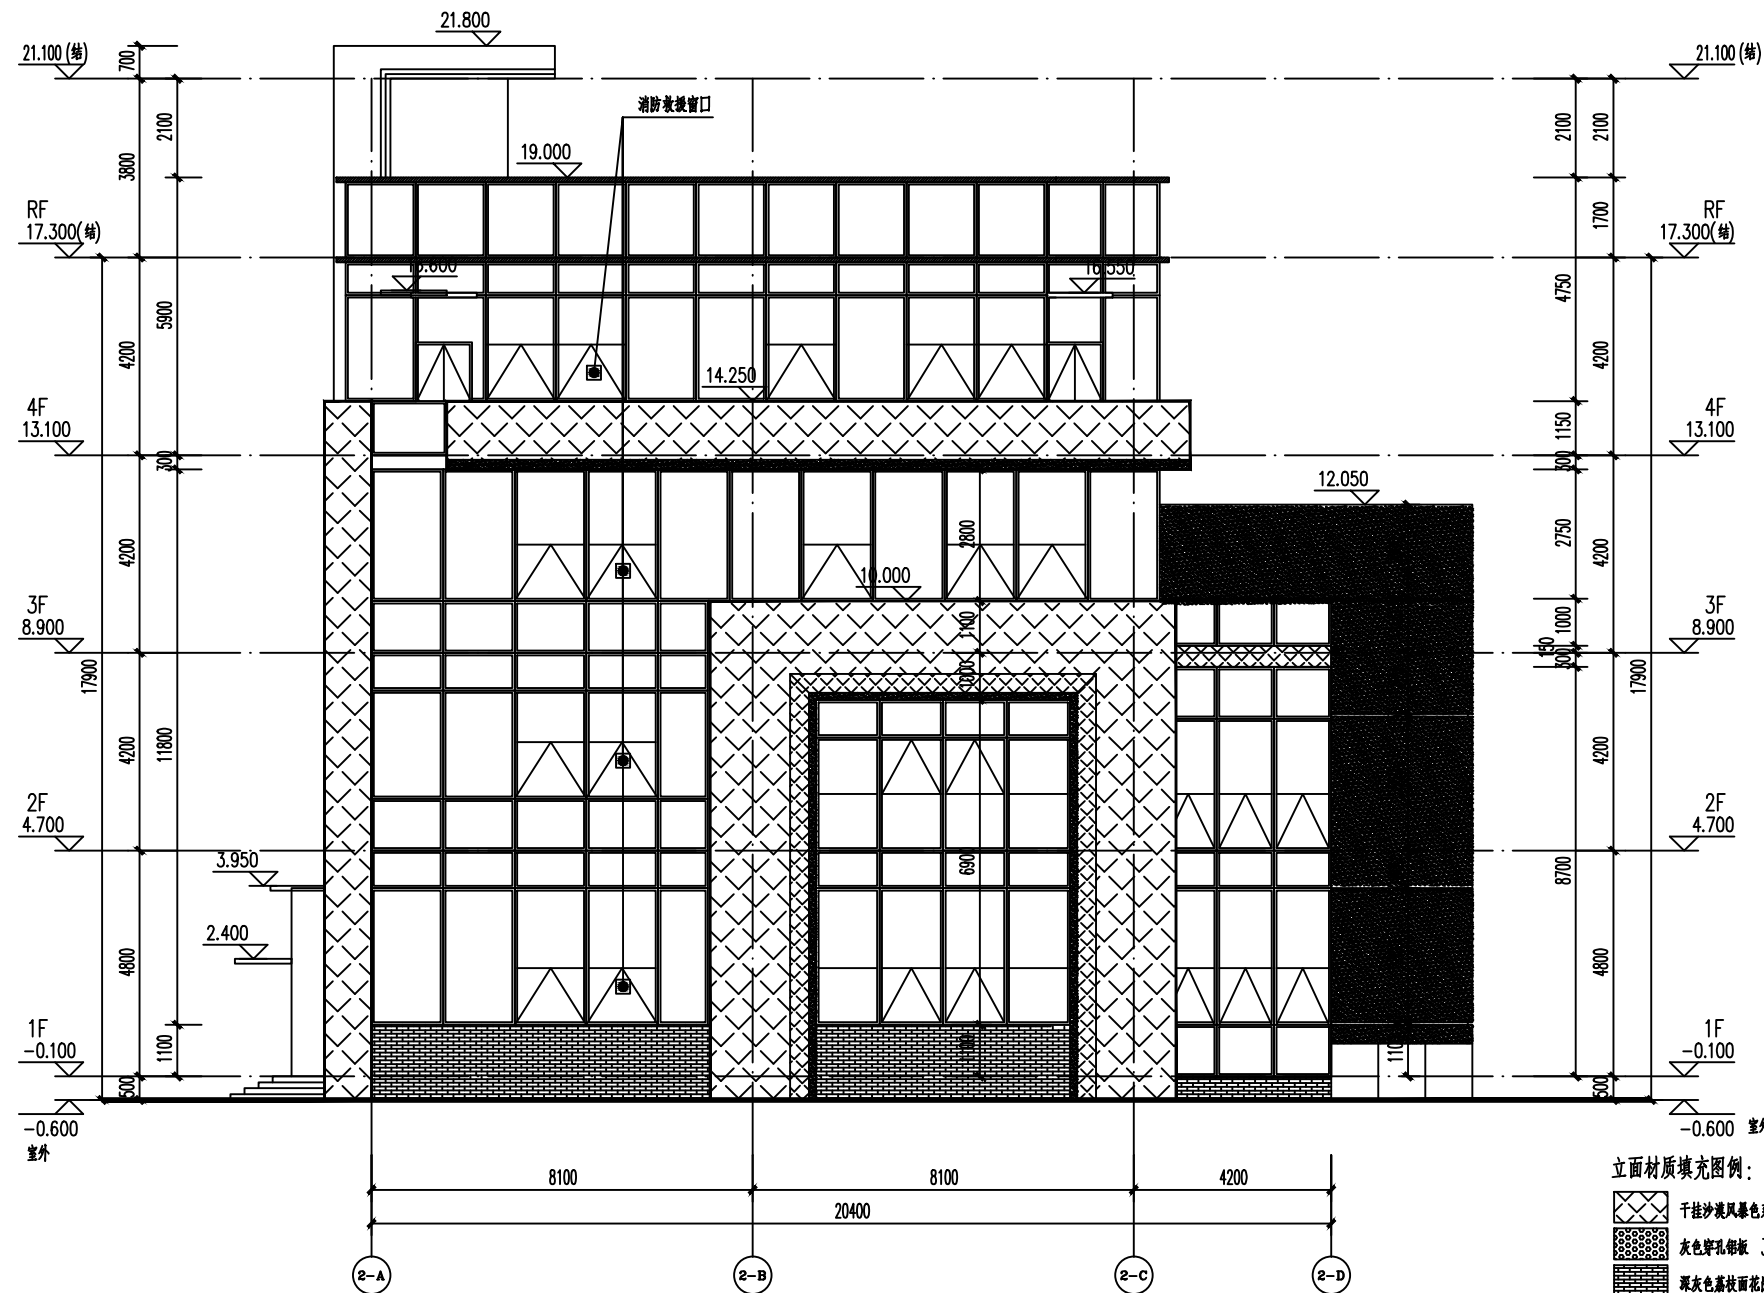

②-A轴~②-D轴立面图 1:100

- 立面材质填充图例:
- 干挂沙溪凤瀑色系花岗岩 9.4R8.5/1.8
 - 灰色穿孔铝板 3.1B8.5/1
 - 深灰色荔枝面花岗岩 7.5B4.5/1.6
 - 干挂仿木色铝板 06RY7.5/4.8
 - 暗红色百叶 1.9Y6/5.6

专业	DISCIPLINE	??	SIGNATURE
??	??	??	??
??	??	??	??
REFERENCE DRAWINGS

??	DRG No.	????	DRG TITLE.
----	---------	------	------------

2	2017.12	施工	??	??	??	??	??	??
1	2017.09	???	???	???	???	???	???	???
??	??	???	??	??	???	??	??	??
REV.	DATE	DESCRIPTION	BY	CHECKED	CHIEF DESIGNER	REVIEWED	APPROVED	

??	APPROVED BY	??	DATE
??	REVIEWED BY	??	DATE 2017.12
???	CHIEF DESIGNER	??	DATE 2017.12
??	CHECKED BY	??	DATE 2017.12
??	DESIGNED BY	??	DATE 2017.12

?? CLIENT ??????????

CCCC - FHDI ENGINEERING CO., LTD.


中交西南研发中心项目

2号地块(A区) 2#楼


②-A ②-D

??	15S219-SS-DWG-JZ-A0212	??	2
DRG NO.		REV.	

??	DRG SCALE 1:100	????	PLOT SCALE A2 (1:1)
项目副经理 P.M	???	COPYRIGHT	RESERVED

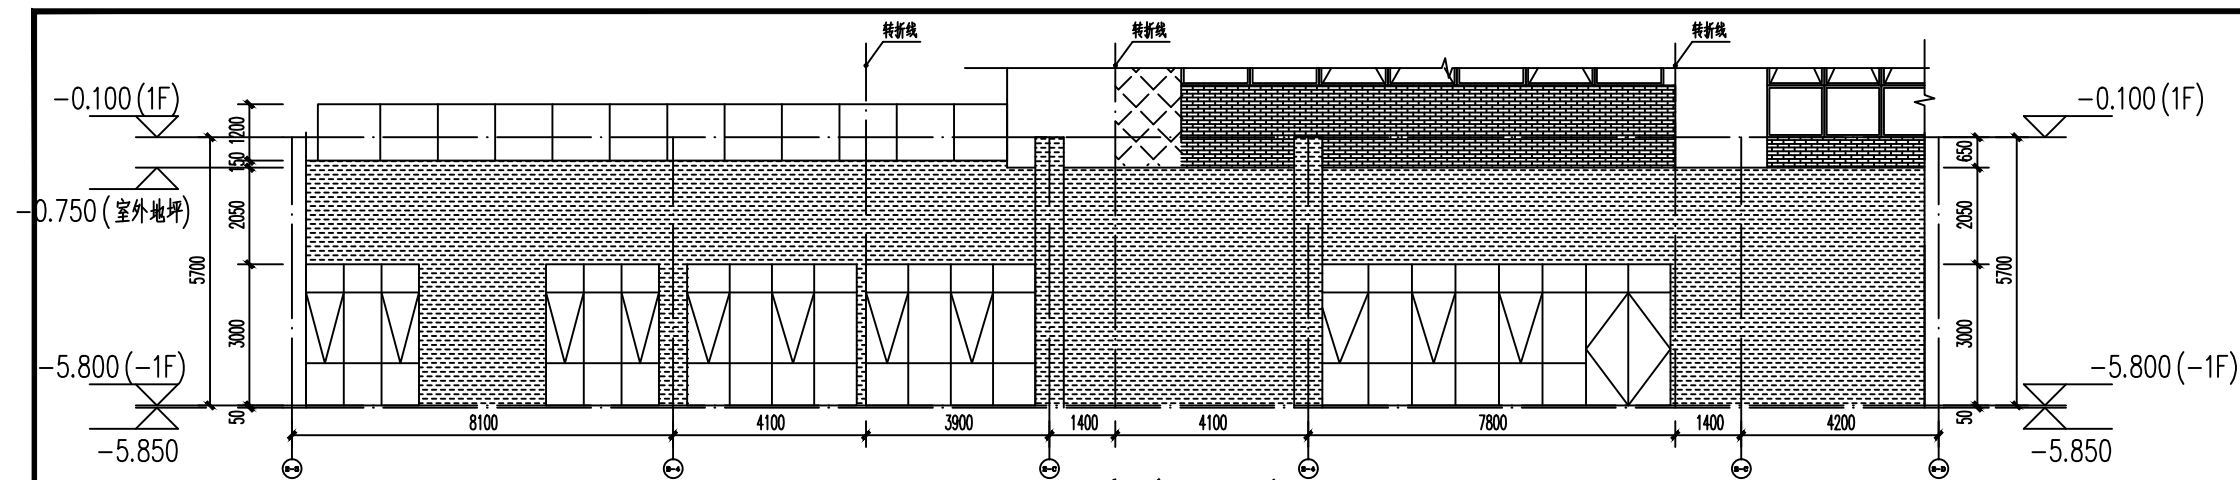

下沉庭院展开立面图 1:100

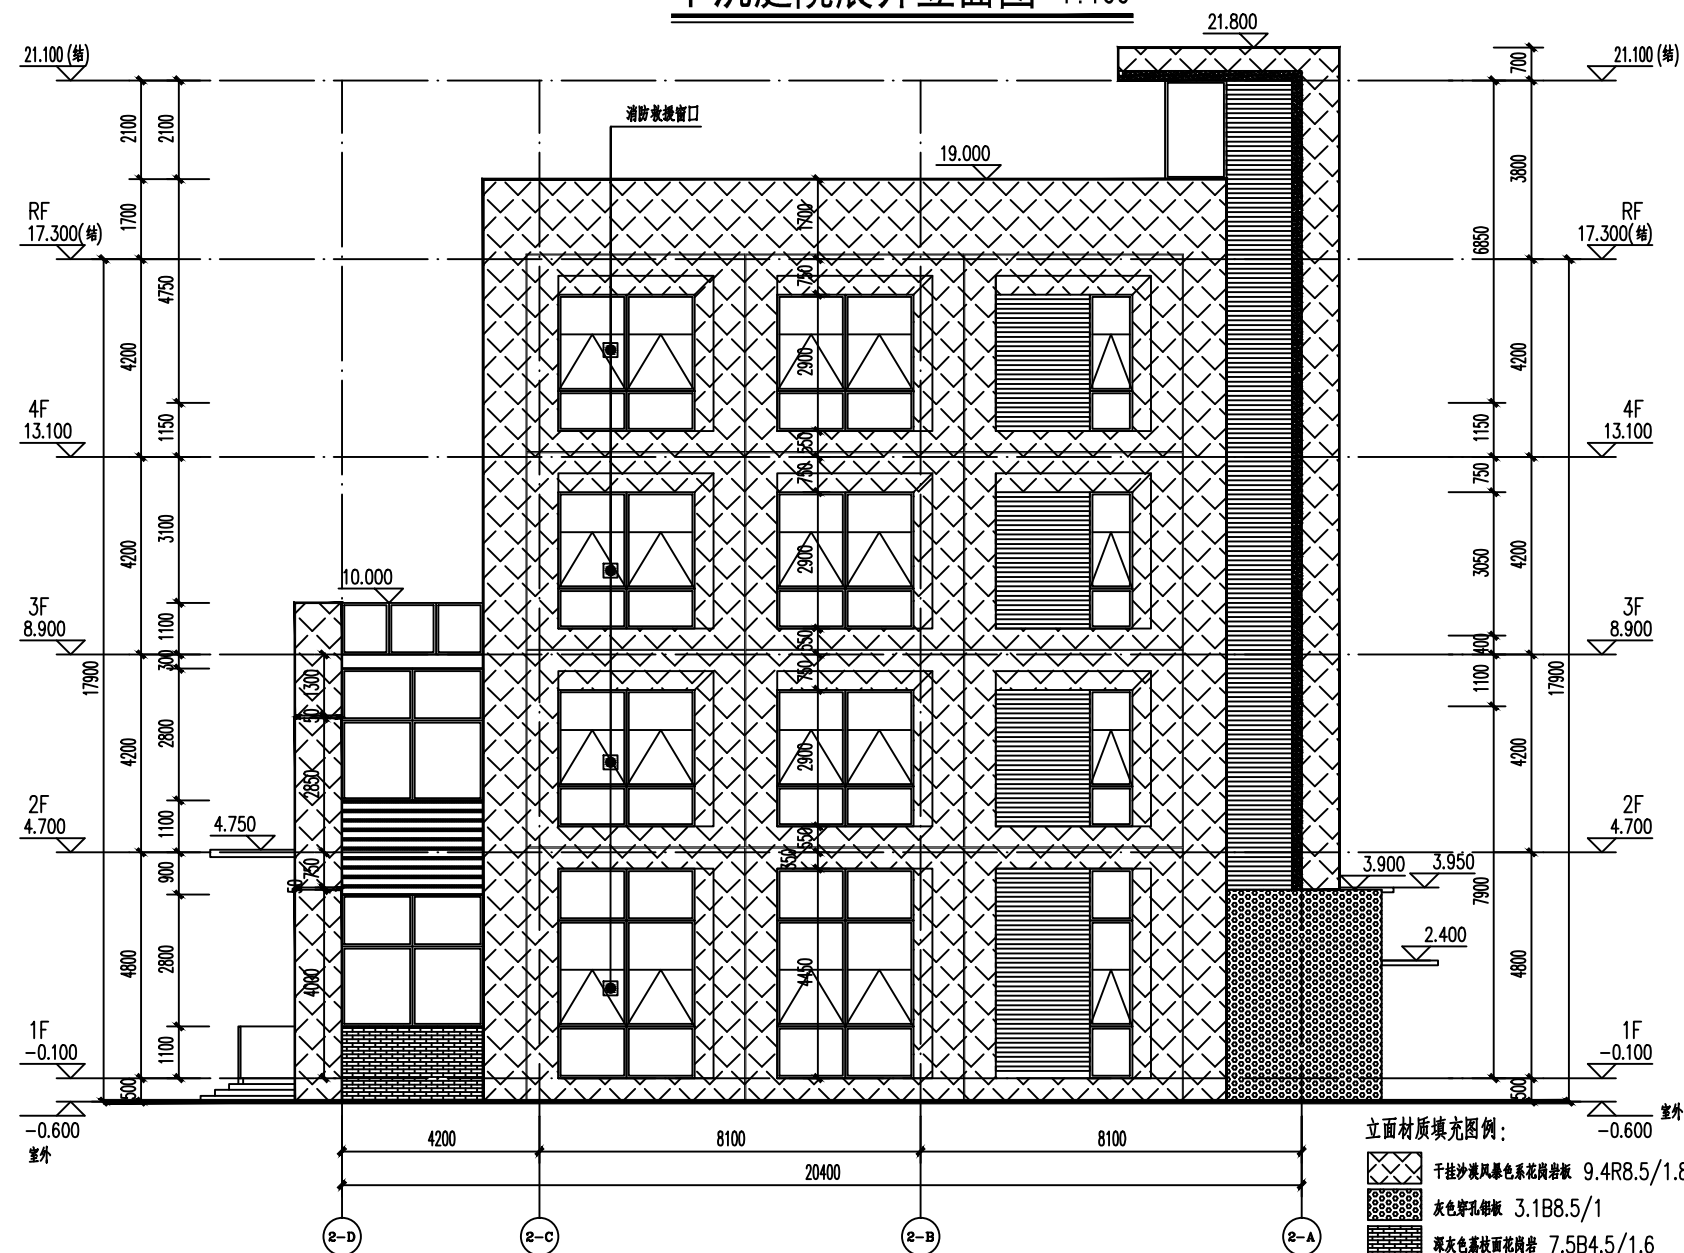


2~D轴~2-A轴立面图 1:100

立面材质填充图例:

- 干挂沙漠风暴色花岗岩板 9.4R8.5/1.8
- 灰色穿孔铝板 3.1B8.5/1
- 深灰色荔枝面花岗岩 7.5B4.5/1.6
- 干挂仿木色铝板 06RY7.5/4.8
- 暗红色百叶 1.9Y6/5.6
- 米白色涂料 8.1Y9/1.2

专业	DISCIPLINE	??	SIGNATURE
??	??	??	??
??	??	??	??
??	DRG No.	???	DRG TITLE.
----	---------	-----	------------

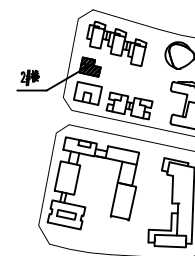

2	2017.12	施工	??	??	??	??	??
1	2017.09	???	???	???	???	???	???
??	??	???	??	??	???	??	??
REV.	DATE	DESCRIPTION	BY	CHECKED	CHIEF DESIGNER	REVIEWED	APPROVED

??	APPROVED BY	??	DATE
??	REVIEWED BY	??	DATE 2017.12
???	CHIEF DESIGNER	??	DATE 2017.12
??	CHECKED BY	??	DATE 2017.12
??	DESIGNED BY	??	DATE 2017.12

?? CLIENT ???????????

CCCC - FHDI ENGINEERING CO., LTD.

中交西南研发中心项目

2号地块(A区) 2#楼

2~D 2~A

??	15S219-SS-DWG-JZ-A0213	??	2
??	DRG SCALE 1:100	???	PLOT SCALE A2 (1:1)
??	???	???	COPYRIGHT RESERVED